


茅野都市計画事業
宮川茅野土地区画整理事業

出来形画地確定図 縮尺 1 : 500

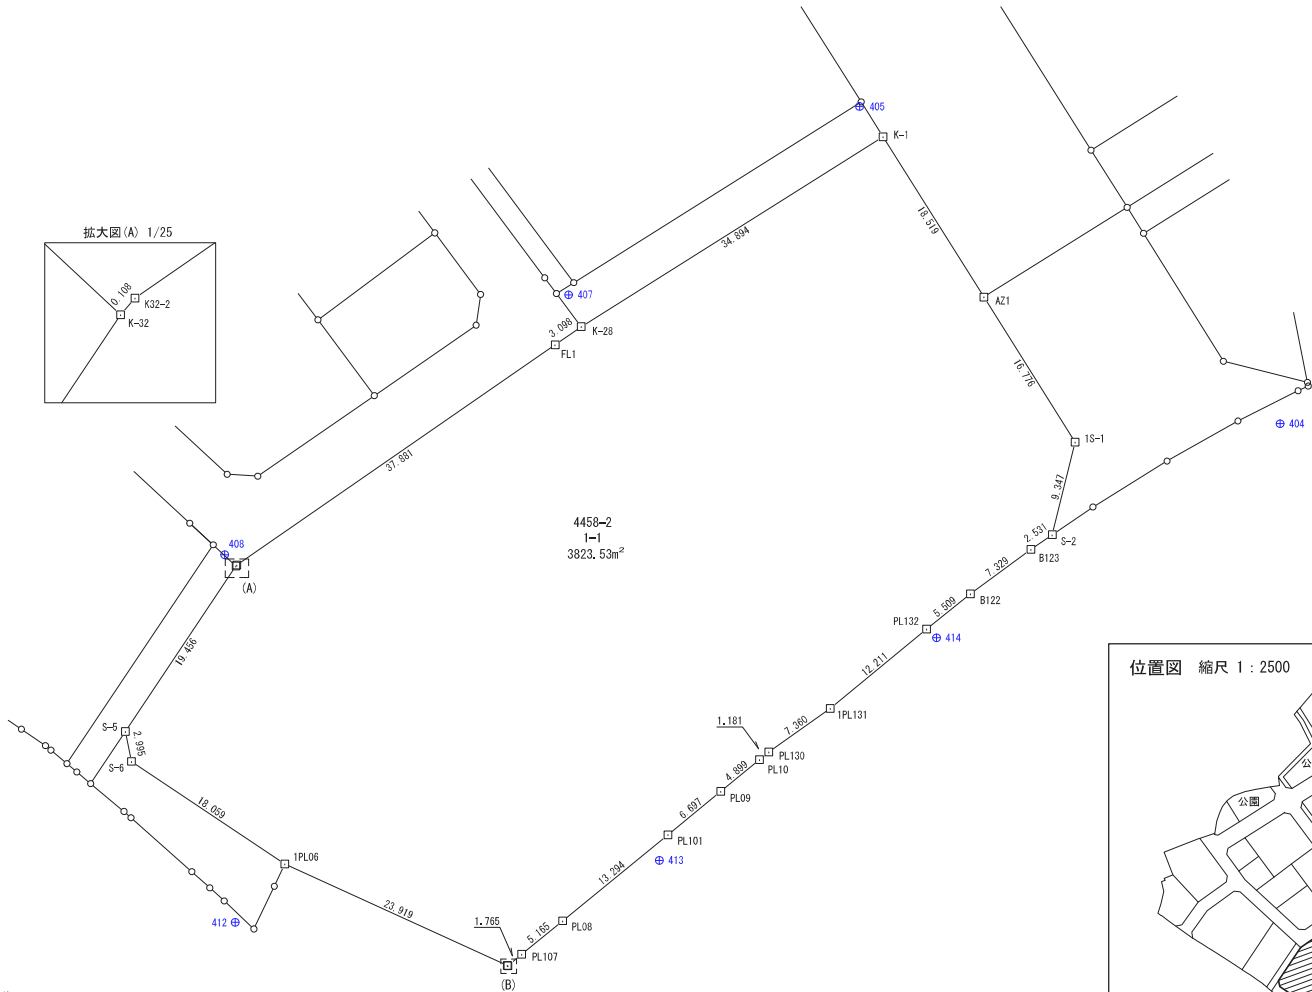


境界点座標一覧表

世界測地系(測地成果2011)		
測点	X	Y
K-1	-1391.217	-31103.145
AZ1	-1406.888	-31093.277
S-1	-1421.087	-31084.342
S-2	-1430.161	-31086.588
B123	-1431.590	-31088.678
B122	-1435.930	-31094.585
PL132	-1439.390	-31098.873
1PL131	-1447.152	-31108.300
PL130	-1451.400	-31114.311
PL10	-1452.165	-31115.211
PL09	-1455.266	-31119.004
PL101	-1459.507	-31124.188
PL08	-1467.924	-31134.479
PL107	-1471.196	-31138.476
PL07	-1472.325	-31139.833
1PL108	-1472.296	-31139.897
1PL06	-1462.375	-31161.662
S-6	-1452.335	-31176.674
S-5	-1449.394	-31177.243
K-32	-1433.211	-31166.442
K32-2	-1433.129	-31166.371
FL1	-1411.577	-31135.218
K-28	-1409.802	-31132.678


基準点座標一覧表

世界測地系(測地成果2011)		
測点	X	Y
N0, 20-BP192K37	-1490.195	-31126.781
404	-1419.291	-31064.280
405	-1388.255	-31105.438
407	-1406.678	-31133.897
408	-1432.109	-31167.538
412	-1468.069	-31166.516
413	-1462.014	-31125.022
414	-1440.231	-31097.900

標識の種類
□ 金属プレート

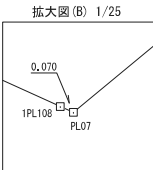

位置図 縮尺 1 : 2500

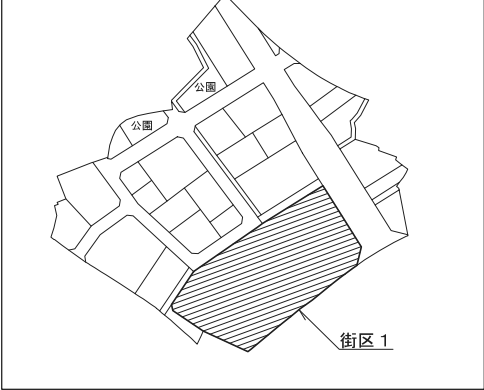

茅野都市計画事業
宮川茅野土地区画整理事業

出来形画地確定図 縮尺 1 : 500




境界点座標一覧表 世界測地系(測地成果2011)

測点	X	Y
KT-35	-1420,973	-31179,679
K-24	-1431,136	-31168,672
K-23	-1452,549	-31182,976
1PL02	-1451,225	-31184,550
1PL117	-1450,783	-31185,080
1PL20	-1449,178	-31187,430
1PL21	-1447,673	-31189,633
1PL22	-1446,592	-31191,223
1PL116	-1445,591	-31192,699
1PL28	-1444,085	-31194,959
KT-36	-1444,024	-31195,052
1PL26	-1439,747	-31201,534
1PL115	-1439,445	-31202,019
1PL32	-1434,770	-31209,339
1PL109	-1433,355	-31211,599
1PL113	-1431,355	-31214,815
1PL36	-1429,886	-31217,214
1PL37	-1429,498	-31217,846
1PL112	-1428,997	-31218,656
IS-8	-1428,628	-31219,169
S-7	-1425,671	-31219,632
EL3	-1415,245	-31212,159
S-10	-1405,726	-31198,968
S-9	-1405,932	-31195,987


基準点座標一覧表 世界測地系(測地成果2011)

測点	X	Y
408	-1432,109	-31167,538
410	-1398,791	-31194,972
411	-1429,345	-31220,051
412	-1468,069	-31166,516
S4	-1394,844	-31268,748

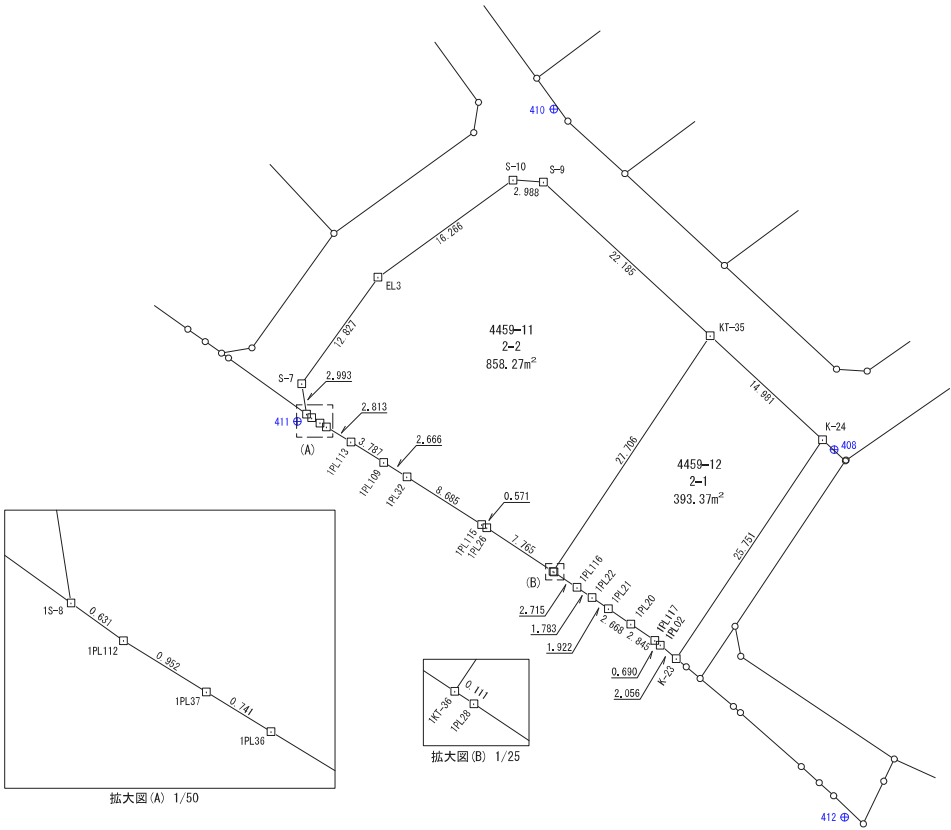

標識の種類
□ 金属プレート

位置図 縮尺 1 : 2500

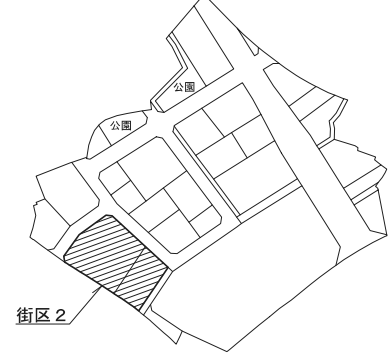

茅野都市計画事業
宮川茅野土地区画整理事業

出来形画地確定図 縮尺 1 : 500



境界点座標一覧表

世界測地系(測地成果2011)


測点	X	Y
1K-18	-1379,790	-31215,707
S-14	-1398,132	-31202,337
S-13	-1401,091	-31202,799
ER3	-1410,947	-31216,477
S-12	-1422,149	-31224,496
IS-11	-1422,668	-31227,466
1PL40	-1421,541	-31229,063
1PL41	-1420,332	-31230,773
PL43	-1417,626	-31234,583
PL44	-1417,459	-31234,822
1PL45	-1417,322	-31235,022
PL46	-1416,948	-31235,558
PL47	-1416,438	-31236,300
1G264	-1416,268	-31236,252
G265	-1411,883	-31234,782
G266	-1405,855	-31233,483
G267	-1400,940	-31234,492
IS53	-1400,345	-31232,708
IS52	-1399,335	-31233,277
SN71	-1397,606	-31228,897
SP38	-1386,506	-31233,235
9SP10	-1380,031	-31216,418

基準点座標一覧表



世界測地系(測地成果2011)

測点	X	Y
409	-1375,646	-31218,609
410	-1398,791	-31194,972
411	-1429,345	-31220,051
S4	-1394,844	-31268,748


拡大図(B) 1/50

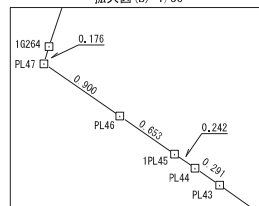

拡大図(A) 1/100

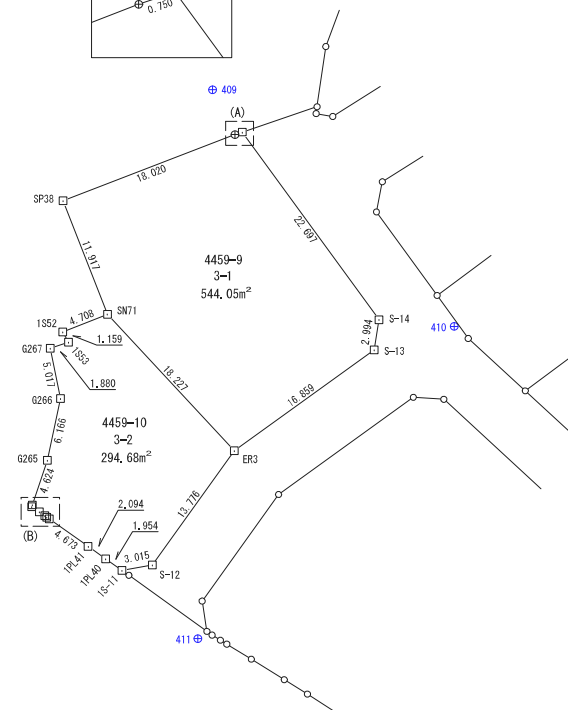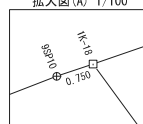

位置図 縮尺 1 : 2500

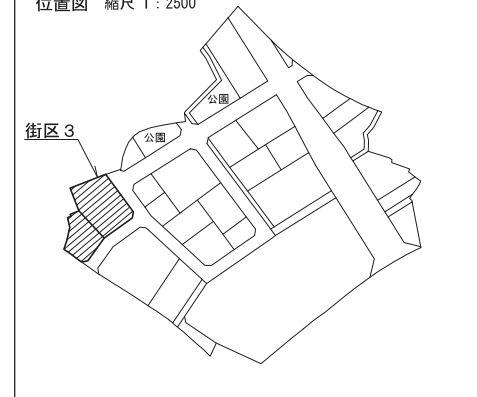


標識の種類

□	金属プレート
⊕	金属板

茅野都市計画事業
宮川茅野土地区画整理事業

出来形画地確定図 縮尺 1 : 500

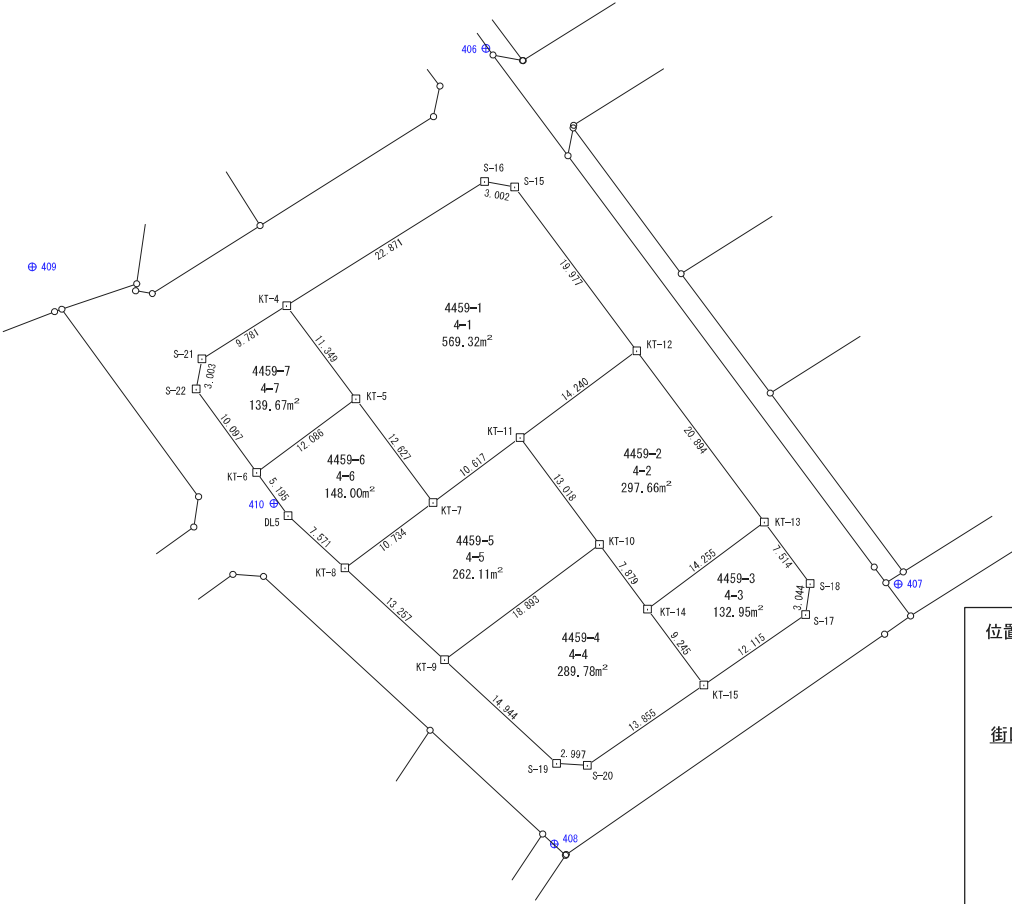

境界点座標一覧表 世界測地系(測地成果2011)


測 点	X	Y
S-16	-1367.289	-31174.354
S-15	-1367.835	-31171.402
KT-12	-1383.855	-31159.466
KT-13	-1400.614	-31146.988
S-18	-1406.642	-31142.502
S-17	-1409.654	-31142.944
KT-15	-1416.546	-31152.908
S-20	-1424.419	-31164.309
S-19	-1424.237	-31167.301
KT-9	-1414.088	-31178.271
KT-8	-1405.103	-31188.020
DL5	-1399.974	-31193.589
KT-6	-1395.770	-31196.642
S-22	-1387.602	-31202.579
S-21	-1384.653	-31202.007
KT-4	-1379.454	-31193.722
KT-5	-1388.557	-31186.944
KT-7	-1398.691	-31179.411
KT-11	-1392.355	-31170.891
KT-10	-1402.800	-31163.120
KT-14	-1409.126	-31158.423

基準点座標一覧表 世界測地系(測地成果2011)

測 点	X	Y
406	-1354.263	-31174.216
407	-1406.678	-31133.897
408	-1432.109	-31167.538
409	-1375.646	-31218.609
410	-1398.791	-31194.972



標識の種類
□ 金属プレート

位置図 縮尺 1 : 2500

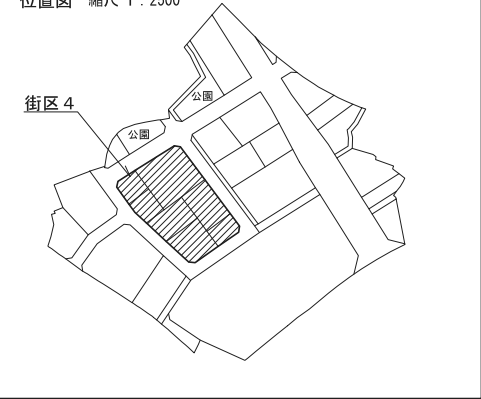

茅野都市計画事業
宮川茅野土地区画整理事業

出来形画地確定図 縮尺 1 : 500

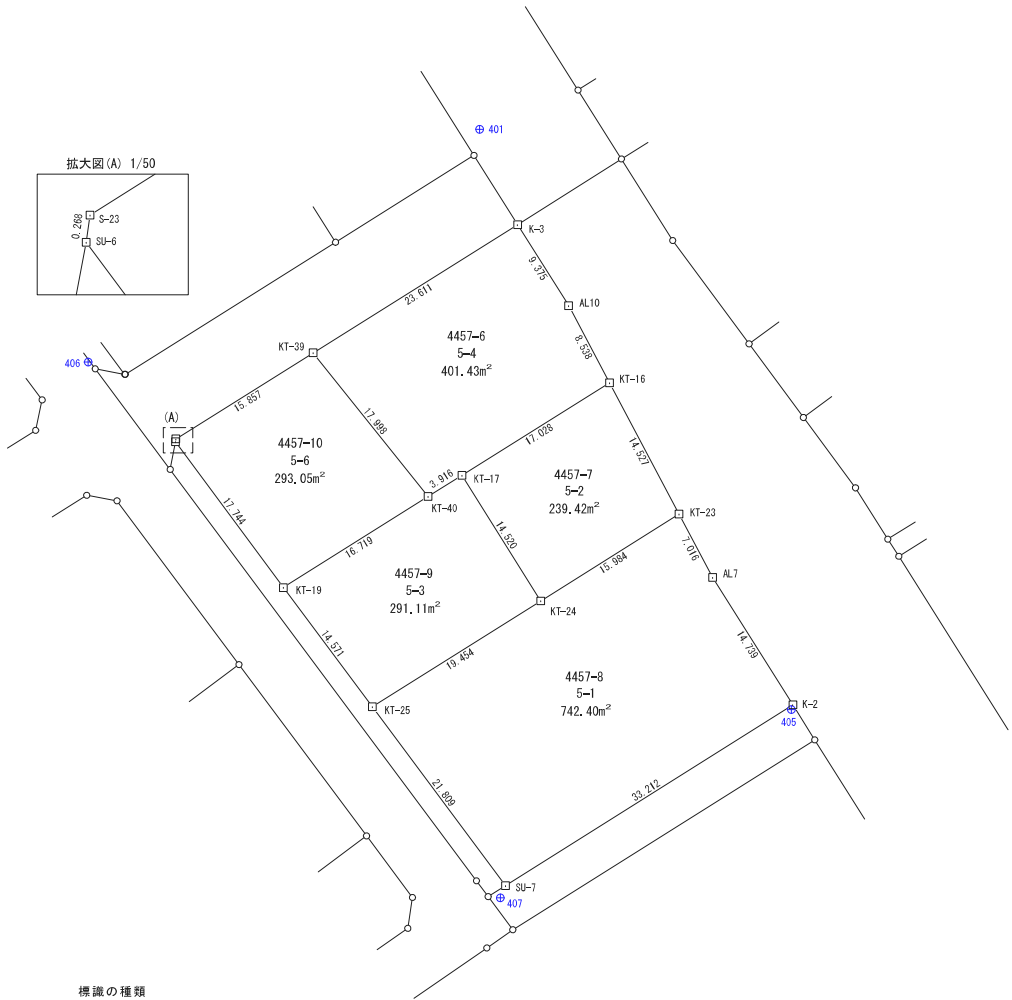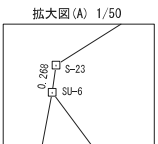


境界点座標一覧表 世界測地系(測地成果2011)

測点	X	Y
K-3	-1340.814	-31132.216
AL10	-1348.743	-31127.212
KT-16	-1356.291	-31123.220
KT-23	-1369.125	-31116.413
AL7	-1375.328	-31113.133
K-2	-1387.802	-31105.282
SU-7	-1405.490	-31133.393
KT-25	-1387.992	-31146.412
KT-19	-1376.311	-31155.123
SU-6	-1362.054	-31165.687
S-23	-1361.788	-31165.651
KT-39	-1353.361	-31152.218

基準点座標一覧表 世界測地系(測地成果2011)



測点	X	Y
401	-1331.491	-31135.926
405	-1388.255	-31105.438
406	-1354.263	-31174.216
407	-1406.678	-31133.897

標識の種類
□ 金属プレート

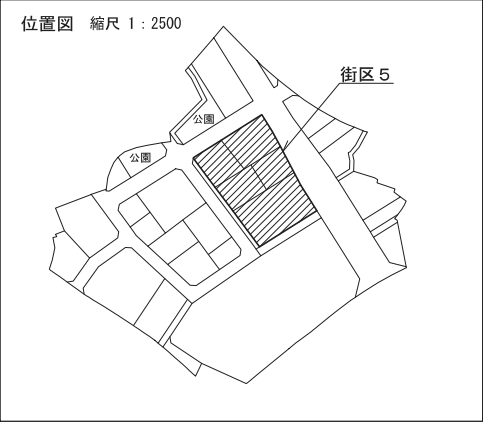

茅野都市計画事業
宮川茅野土地区画整理事業

出来形画地確定図 縮尺 1 : 500

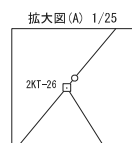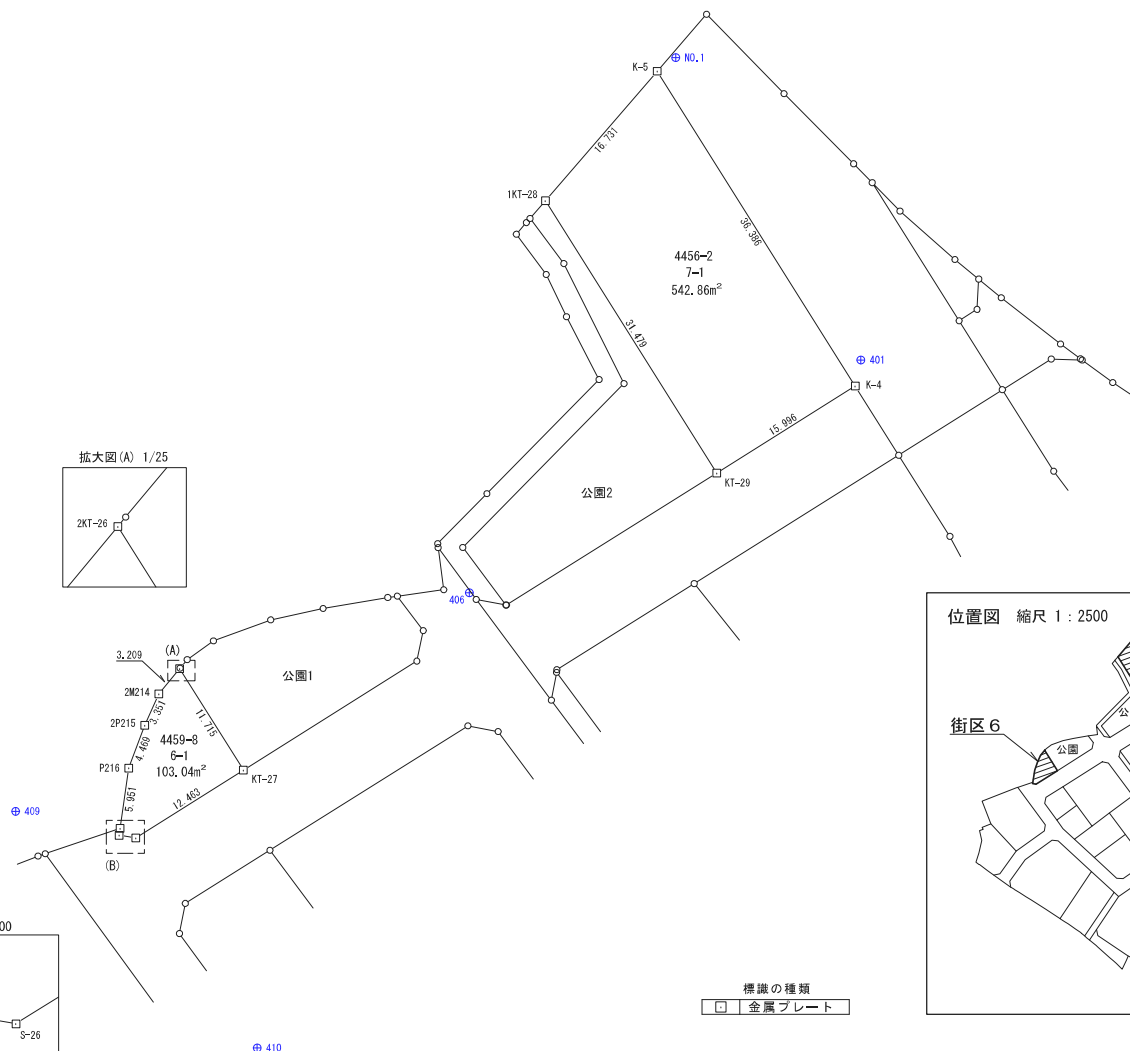

(4459-8)

境界点座標一覧表

世界測地系(測地成果2011)

測点	X	Y
2KT-26	-1361.692	-31202.558
KT-27	-1371.608	-31196.319
S-26	-1378.259	-31206.859
K-36	-1377.981	-31208.485
1P217	-1377.301	-31208.386
P216	-1371.411	-31207.531
2P215	-1367.225	-31205.965
2M214	-1364.160	-31204.610

(4456-2)

境界点座標一覧表



世界測地系(測地成果2011)

測点	X	Y
K-5	-1303.235	-31155.838
K-4	-1334.040	-31136.473
KT-29	-1342.543	-31150.022
1KT-28	-1315.894	-31166.779

基準点座標一覧表

世界測地系(測地成果2011)

測点	X	Y
NO.1	-1301.906	-31154.035
401	-1331.491	-31135.926
406	-1354.263	-31174.216
409	-1375.646	-31218.609
410	-1398.791	-31194.972

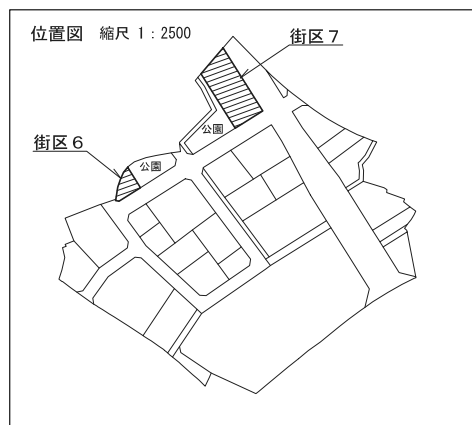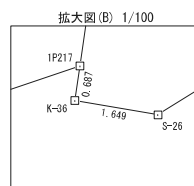

茅野都市計画事業
宮川茅野土地区画整理事業

出来形画地確定図 縮尺 1 : 500

街区番号 8-1、8-2、8-3、9

(4456-1)
境界点座標一覧表

世界測地系(測地成果2011)		
測点	X	Y
K-6	-1314.143	-31134.803
9B024	-1316.916	-31132.081
9B023	-1321.663	-31126.721
S-32	-1323.575	-31124.388
S-31	-1326.538	-31124.555
K-35	-1327.646	-31126.307

(4457-1、4457-2、4457-3)

境界点座標一覧表

世界測地系(測地成果2011)		
測点	X	Y
9S-33	-1331.497	-31114.258
KZ019	-1333.699	-31111.248
9KZ018	-1337.173	-31106.020
KZ017	-1338.484	-31103.893
9KZ016	-1340.942	-31099.582
1KT-30	-1342.676	-31096.337
KZ015	-1343.098	-31095.547
KZ014	-1343.838	-31094.082
KZ013	-1345.612	-31090.302
9KT-32	-1346.928	-31087.010
9KZ046	-1348.642	-31082.722
9SU-12	-1348.674	-31082.645
SU-13	-1355.651	-31086.426
SU-14	-1358.904	-31089.079
SU-15	-1359.441	-31089.947
SU-16	-1363.334	-31089.247
SU-17	-1367.420	-31089.367
1SU-18	-1371.580	-31095.993
AR7	-1366.558	-31099.156
KT-33	-1359.680	-31104.248
KT-31	-1352.470	-31109.559
AR10	-1342.366	-31117.036
K-34	-1334.391	-31122.056
S-34	-1331.394	-31117.281

(4457-4、4457-5)

境界点座標一覧表

世界測地系(測地成果2011)		
測点	X	Y
D453-1	-1368.521	-31087.387
9D461-1	-1371.603	-31077.144
9D454	-1372.604	-31075.668
D455-2	-1374.072	-31075.965
D456-1	-1377.154	-31067.194
D457-1	-1378.591	-31067.657
1KT-38	-1381.005	-31064.427
D459	-1383.098	-31061.627
KZ080	-1384.849	-31062.528
1KZ079	-1387.157	-31063.825
1SU-8	-1389.623	-31065.691
SU-10	-1398.114	-31079.257
KT-37	-1392.531	-31082.793
9SU-19	-1373.264	-31094.917

(4458-1)

境界点座標一覧表

世界測地系(測地成果2011)		
測点	X	Y
1SU-9	-1393.336	-31065.956
1S-4	-1415.239	-31061.602
1S-3	-1413.180	-31069.821
SU-11	-1400.673	-31077.650


基準点座標一覧表

世界測地系(測地成果2011)


測点	X	Y
401	-1331.491	-31135.926
402	-1342.003	-31097.505
403	-1381.772	-31061.590
404	-1419.291	-31064.280
405	-1388.255	-31105.438
S1	-1355.525	-31059.945

標識の種類

□	金属プレート
☒	プラスチック杭
⊕	金属杭
▽	刻み

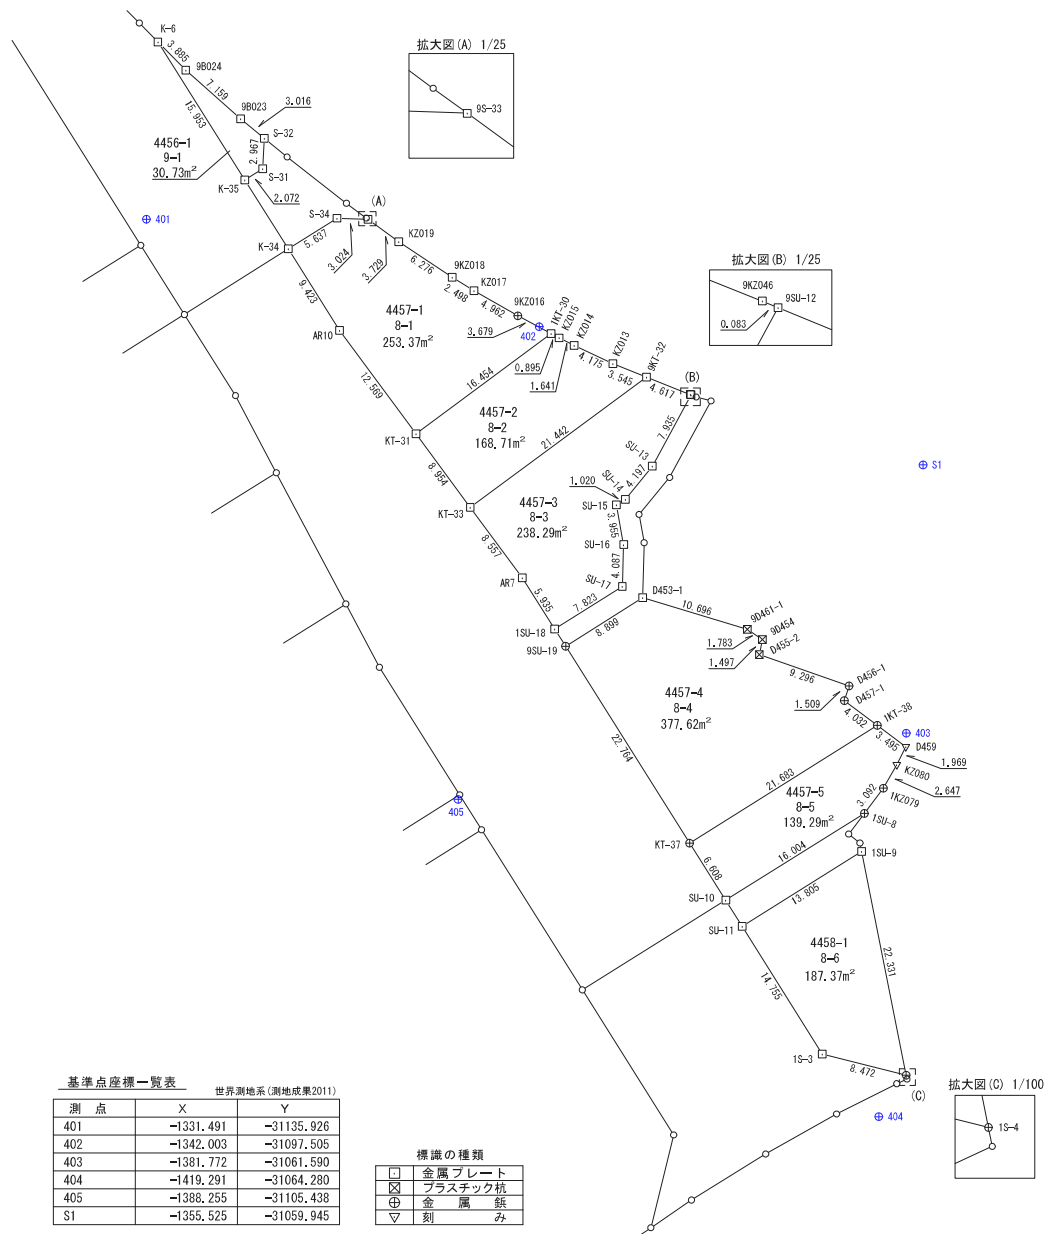

位置図 縮尺 1 : 2500

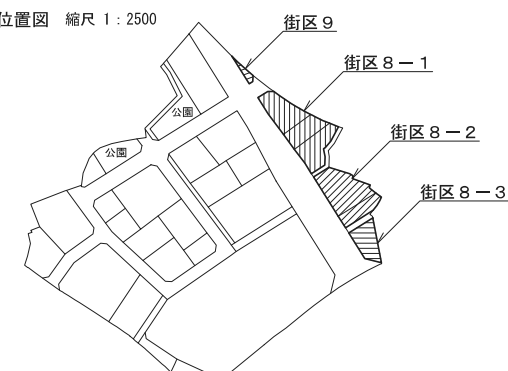

拡大図(C) 1/100

